



Architecture Plus, Inc. • August 19, 2020 • 8:30am • File located @ P:\2016\16-27-02 Huntsville Schools - Activity Center\Architecture\16-27-02\_A1.1A.dwg • Created by jballon@archplusinc.net

- Red = Alert Beacon
- Yellow = Access Point
- Blue = Data Cat 6 to network room
- Orange = Power & Junction Box to IT Rm for TV
- Purple = Camera
- Black = Junction Box

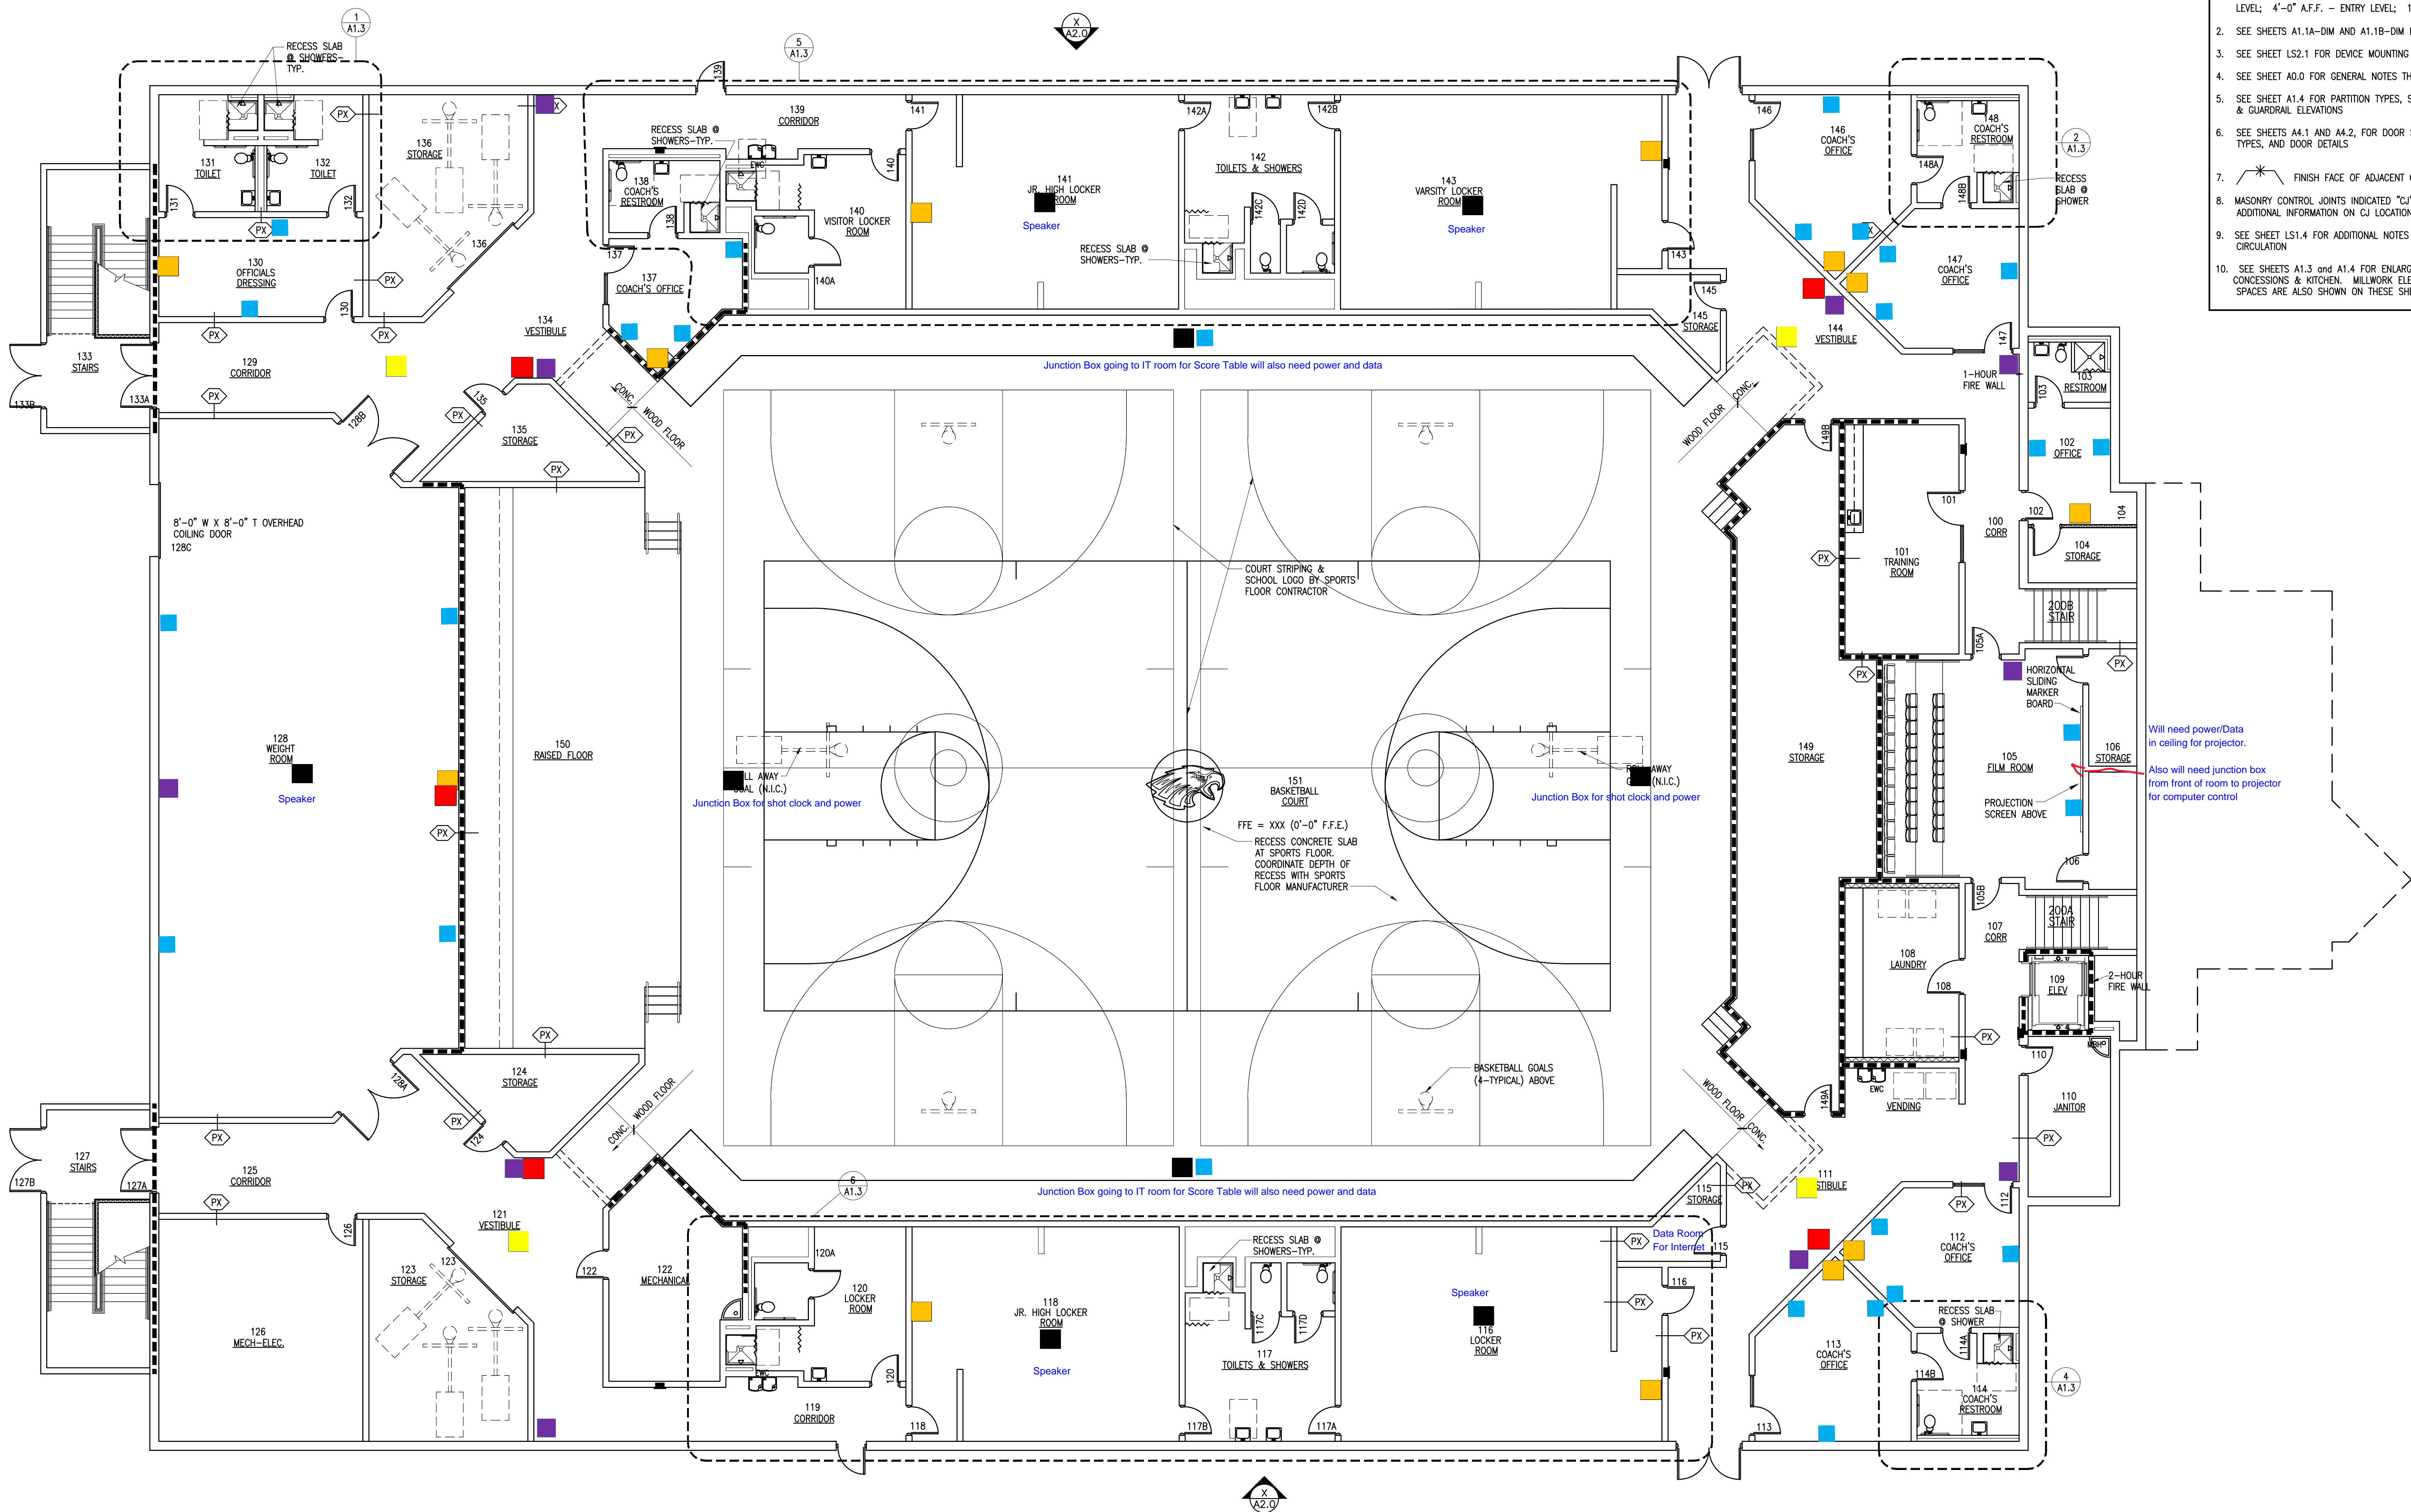

HUNTSVILLE ACTIVITY CENTER  
LOWER LEVEL  
DATA AND OTHER FOR MARKUP

1 ARCHITECTURAL FLOOR PLAN - LOWER LEVEL  
SCALE: 1/8" = 1'-0"

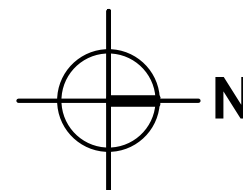

ROOM FINISH SCHEDULE			
FLOOR	BASE	WALLS	
A SEALED CONCRETE	1 RUBBER, 4"	A CMU-PAINT	
B SHEET VINYL	2 NONE	B CMU-PAINT, EPOXY	
C WOOD SPORTS FLOOR	3 WOOD	C CMU-UNFINISHED (PREPARED FOR PAINT)	
D LVT	4 EPOXY	D GYPSUM BOARD - PAINT	
E CARPET	5	E PERFORATED METAL WALL/LINER PANELS	
F RUBBER	6	F NONE	
G RUBBER TREADS & RISERS	7	G WOOD CHAIR RAIL	
H WALK-OFF CARPET TILE			
J TROWELED FLOORING (EPOXY FLOOR)			

F.E.C. = FIRE EXTINGUISHER CABINET  
M.T. = METAL THRESHOLD  
M.O. = MASONRY OPENING  
M.B.H. = MOP & BROOM HOLDER  
E.W.C. = ELECTRIC WATER COOLER

R.S. = ROLLER SHADE  
M.B. = MINI BLINDS  
AM = AMBULATORY FIXTURE  
S = STANDARD FIXTURE  
HC = HANDICAP FIXTURE  
S.B. = SMART BOARD

FLOOR **A1.1A** - WALLS

"A/B" DENOTES TWO FINISH CONDITIONS W/IN THE ROOM. FOR A SPECIFIED LOCATION SUCH AS "WALLS".

NOTES: 1. EPOXY PAINT ALL WALLS, RESTROOMS & TLTS  
2. REFER TO REFLECTED CEILING PLAN FOR CEILING HEIGHTS & MATERIALS  
3. SEE SHEET F1.1 FOR FLOOR PATTERN PLAN  
4. SEE SHEET F1.1 FOR COLOR & MATERIAL SCHEDULE

- NOTES:**
- FLOOR SPOT ELEVATIONS ARE SHOWN THUS: 0'-0" F.F.E. - LOWER LEVEL; 4'-0" A.F.F. - ENTRY LEVEL; 12'-8" A.F.F. - MAIN LEVEL.
  - SEE SHEETS A1.1A-DIM AND A1.1B-DIM FOR DIMENSIONED FLOOR PLANS.
  - SEE SHEET LS2.1 FOR DEVICE MOUNTING HEIGHTS.
  - SEE SHEET A0.0 FOR GENERAL NOTES THAT APPLY TO ALL DRAWINGS.
  - SEE SHEET A1.4 FOR PARTITION TYPES, SEATING HAND RAIL & GUARDRAIL ELEVATIONS.
  - SEE SHEETS A4.1 AND A4.2 FOR DOOR SCHEDULE, DOOR AND FRAME TYPES, AND DOOR DETAILS.
  - FINISH FACE OF ADJACENT CONSTRUCTION TO ALIGN
  - MASONRY CONTROL JOINTS INDICATED "CJ" SEE STRUCTURAL FOR ADDITIONAL INFORMATION ON CJ LOCATIONS
  - SEE SHEET LS1.4 FOR ADDITIONAL NOTES & DIMENSIONS FOR VERTICAL CIRCULATION
  - SEE SHEETS A1.3 AND A1.4 FOR ENLARGED PLANS OF RESTROOMS, CONCESSIONS & KITCHEN. MILLWORK ELEVATION SYMBOLS FOR THOSE SPACES ARE ALSO SHOWN ON THESE SHEETS.

NEW ACTIVITY CENTER  
HUNTSVILLE SCHOOL DISTRICT  
HUNTSVILLE, ARKANSAS

ARCHITECTURE PLUS, INC.  
907 South 21st Street Fort Smith, Arkansas 479/783-8395

FLOOR PLAN - LOWER LEVEL

REVISIONS:  
HUNTSVILLE PLANNING  
PRELIMINARY REVIEW 08-12-20

PROJECT: 16-27.02  
DATE: 07-17-2020

A1.1A

ARCHITECTS • PLANNERS

NOT FOR CONSTRUCTION